

APPLICATION FOR ELECTRICAL PERMIT

1

COUNTY OF LOS ANGELES
DEPARTMENT OF COUNTY ENGINEER
BUILDING AND SAFETY DIVISION
JOHN A. LAMBIE, COUNTY ENGINEER
WILLIAM A. JENSEN, SUP'T OF BUILDING

FOR APPLICANT TO FILL IN

RECEPT.	TOTAL OUTLETS	FIRST 20	NO.	EACH	FEE
LIGHT	1	ADD'L OVER 20		\$.20	20
SWITCH.				.10	
LIGHTING FIXTURES	TOTAL	FIRST 20		.20	
		ADD'L OVER 20		.10	
RANGES	CLO. DRYERS	WTR. HTRS.		1.00	
GARB. DISP.	STA. COOK				
DISHWASH.	AUTO.-WASH.				
SPACE HTRS.	STA. APP. (1/2 H.P. MAX.)			.50	
MOTORS:	OVER	NOT OVER	H.P.		
	0	1		1.00	
	1	3		1.50	
	3	8		2.00	
	8	15		2.50	
	15	50		3.00	
	50	100		5.00	
SIGNS:	NO. TRANS.				
	NO. LAMPS				
SERVICE 0-600V.-NOT OVER 200A				1.00	
SERVICE 0-600V.-OVER 200 A.				2.00	
SERVICE OVER 600V				5.00	
MISC.					
PERMIT ISSUING FEE				2.00	2.00
SUPPLEMENTARY PERMIT ISSUING FEE				1.00	
TOTAL FEE				\$	2.20

I HEREBY ACKNOWLEDGE THAT I HAVE READ THIS APPLICATION AND STATE THAT THE ABOVE IS CORRECT AND AGREE TO COMPLY WITH ALL COUNTY ORDINANCES AND STATE LAWS REGULATING ELECTRICAL WIRING.

I HEREBY CERTIFY THAT I AM PROPERLY REGISTERED AND/OR LICENSED AS REQUIRED BY LOS ANGELES COUNTY AND STATE OF CALIFORNIA OR THAT I AM THE LEGAL OWNER OF THE ABOVE DESCRIBED RESIDENTIAL PROPERTY.

SIGNATURE
OF PERMITTEE

J. Morady

VALIDATION

CK MO CASH

ARTHUR C. VEIT
SUPERVISING ELECTRICAL ENGINEER

LAC 60673 JUN 12 2 A 2.20

Bonham

BUILDING ADDRESS	7943 E. La Merced Rd
LOCALITY	S. San Gabriel
NEAREST CROSS ST.	POTRERO GRANDE
OWNER	Mateen, William
MAIL ADDRESS	7943 E. La Merced Rd.
CITY	S. San Gabriel
TEL. NO.	AT 0-4539
ELECTRICIAN	Guadalupe
ADDRESS	10804 Burbank Blvd.
CITY	No. Hollywood
TEL. NO.	PO 6-4311
STATE LICENSE NO.	195481

DISTRICT NO.	GROUP	ZONE	PROCESSED BY
5	I	A-1	GOLOVKO

INSPECTION RECORD

APPROVALS	DATE	INSPECTOR'S SIGNATURE
CONDUIT	7-23-62	<i>J. Jansen</i>
WIRING		
FIXTURES		
POWER		
UTILITY CO. NOTIFIED	7-23-62	<i>J. Jansen</i>
FINAL		

INSPECTOR COPY

APPLICATION FOR PERMIT
COUNTY OF LOS ANGELES
DEPARTMENT OF COUNTY ENGINEER
BUILDING AND SAFETY DIVISION
JOHN A. LAMBIE, County Engineer
WILLIAM A. JENSEN, Sup't of Building

SEWER-SEWAGE DISPOSAL

1

FOR APPLICANT TO FILL IN		
LEGAL DESCRIPTION	LOT NO.	4
BLOCK	TRACT	9271
SIZE OF LOT	NO. OF BLDGS. NOW ON LOT 1	
USE OF BUILDINGS	RES.	
CONTRACTOR TONY PIPELINE CONST.		
ADDRESS 708 NEW DEPOT ST.		
CITY LOS ANGELES TEL. NO. 2810082		
REGISTRATION NO. 162786		
NO.	DESCRIPTION OF WORK	FEE
1	HOUSE SEWER CONNECTING TO PUBLIC SEWER	@ \$5.00
	SEPTIC TANK, SEEPAGE PIT OR PITS AND/OR DRAINFIELD	@ \$10.00
	HOUSE SEWER CONNECTING TO PRIVATE DISPOSAL SYSTEM	@ \$3.00
	CONNECT ADDITIONAL BLDG. OR WORK TO HOUSE SEWER	@ \$3.00
	OVERFLOW SEEPAGE PIT, DRAINFIELD EXTN., CESSPOOL, DRYWELL, MANHOLE	@ \$5.00
	ALTER, REPAIR OR ABANDON HOUSE SEWER OR DISPOSAL SYSTEM	@ \$3.00
OWNER'S AUTHORIZATION		
PERMIT	\$	2 00
TOTAL FEE		7.00
I HAVE AT THIS DATE A CONTRACT WITH THE HEREIN NAMED CONTRACTOR TO CONNECT THE ABOVE DESCRIBED EXISTING DWELLING TO THE PUBLIC SEWER.		
SIGNED THIS DAY OF 19		
OWNER OR OWNERS AGENT		
ADDRESS		
I HEREBY ACKNOWLEDGE THAT I HAVE READ THIS APPLICATION AND STATE THAT THE ABOVE IS CORRECT AND AGREE TO COMPLY WITH ALL COUNTY ORDINANCES AND STATE LAWS REGULATING PLUMBING AND SEWERS.		
I HEREBY CERTIFY THAT I AM PROPERLY REGISTERED AND/OR LICENSED AS REQUIRED BY LOS ANGELES COUNTY AND STATE OF CALIFORNIA OR THAT I AM THE LEGAL OWNER OF, AND INTEND TO RESIDE IN, THE ABOVE DESCRIBED RESIDENTIAL PROPERTY.		
SIGNATURE OF PERMITTEE		

BUILDING ADDRESS	7943 LA MERCED		
LOCALITY	So. SAN GABRIEL		
NEAREST CROSS ST.	DET MAR		
OWNER	WILLIAM C. MATEER		
MAIL ADDRESS	7943 LA MERCED		
CITY	SAN GABRIEL	STATE	NO. ATO 4529
DISTRICT NO.	GROUP	MAP	PROCESSED BY
5	I	BK PG 141	Roush
CONNECTION DATA			
STATION	4+52.5		DEPTH 8
MANHOLE REFERENCE	127.1		UPPER LOWER
Y.	TYPE OF CONNECTION CURB	P.L.	LENGTH FROM M.L. TO P.L. 35
CO. IMP. NO.	1406		P.C. NO. JOB NO.
TRUNK PERMIT NO.		ROAD PERMIT NO.	
AFFIDAVIT	WAIVER	EASEMENT	RECORD. INSTR. NO. DATE
HWY. OR ST. WIDENING			
STATE ENCROACHMENT PERMIT NO.			
INDUSTRIAL WASTE APPROVAL			
CHARGES			
CONNECTION CHARGE FEE			
REIMBURSEMENT FEE			
APPROVALS		DATE	INSPECTOR'S SIGNATURE
NEW HOUSE SEWER		9-23	gabula
CONNECT ADDITIONAL BUILDING OR WORK			
SEPTIC TANK, SEEP, PIT(S) AND/OR DRAINFIELD			
CESSPOOL DRYWELL		96	
ALTER, REPAIR, SEWER OR SEWAGE DISPOSAL SYSTEM			
DISCONNECT PLUG AND ABANDON HOUSE SEWER			
BACKFILL SEPTIC TANKS SEEP, PIT(S) CESSPOOLS		9-26	gabula

VALIDATION
CK. M. O. CASH
ROBERT A. WOOD
SUPERVISING MECHANICAL ENGINEER

03242 SEP 18 10 A 7.00-


Bonham

INSPECTOR COPY

FOR DEPARTMENT USE

REQUIRED INFORMATION

1. INDICATE ALL BUILDINGS ON PROPERTY.
2. INDICATE AND DIMENSION SEWAGE DISPOSAL SYSTEM WITH TIE DISTANCES TO BUILDINGS AND PROPERTY LINES.
3. INDICATE SIZE OF SEPTIC TANK-DEPTH OF SEEPAGE PIT(S)--SIZE OF CESSPOOL(S).
4. INDICATE NORTH DIRECTION ON PLOT.
5. INDICATE BOTH STREETS IF CORNER.

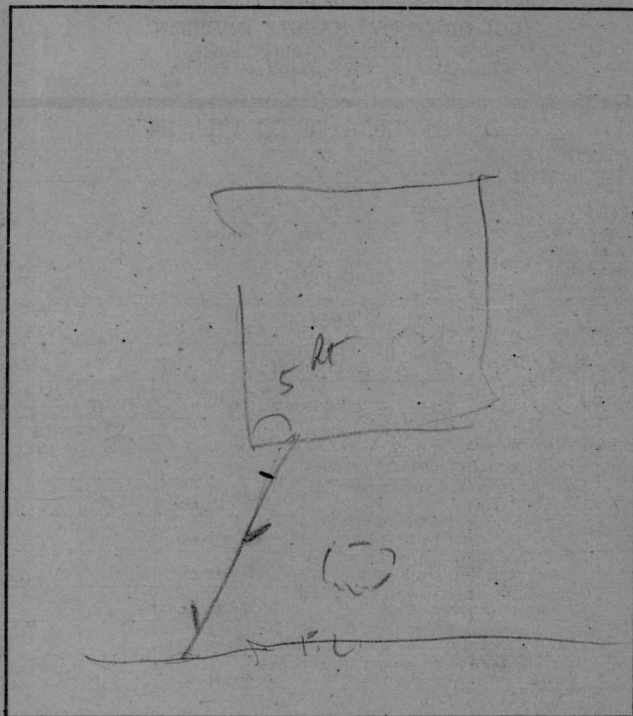

ST. ALLEY R/W

FIELD NOTES

00.7 1018192 245200